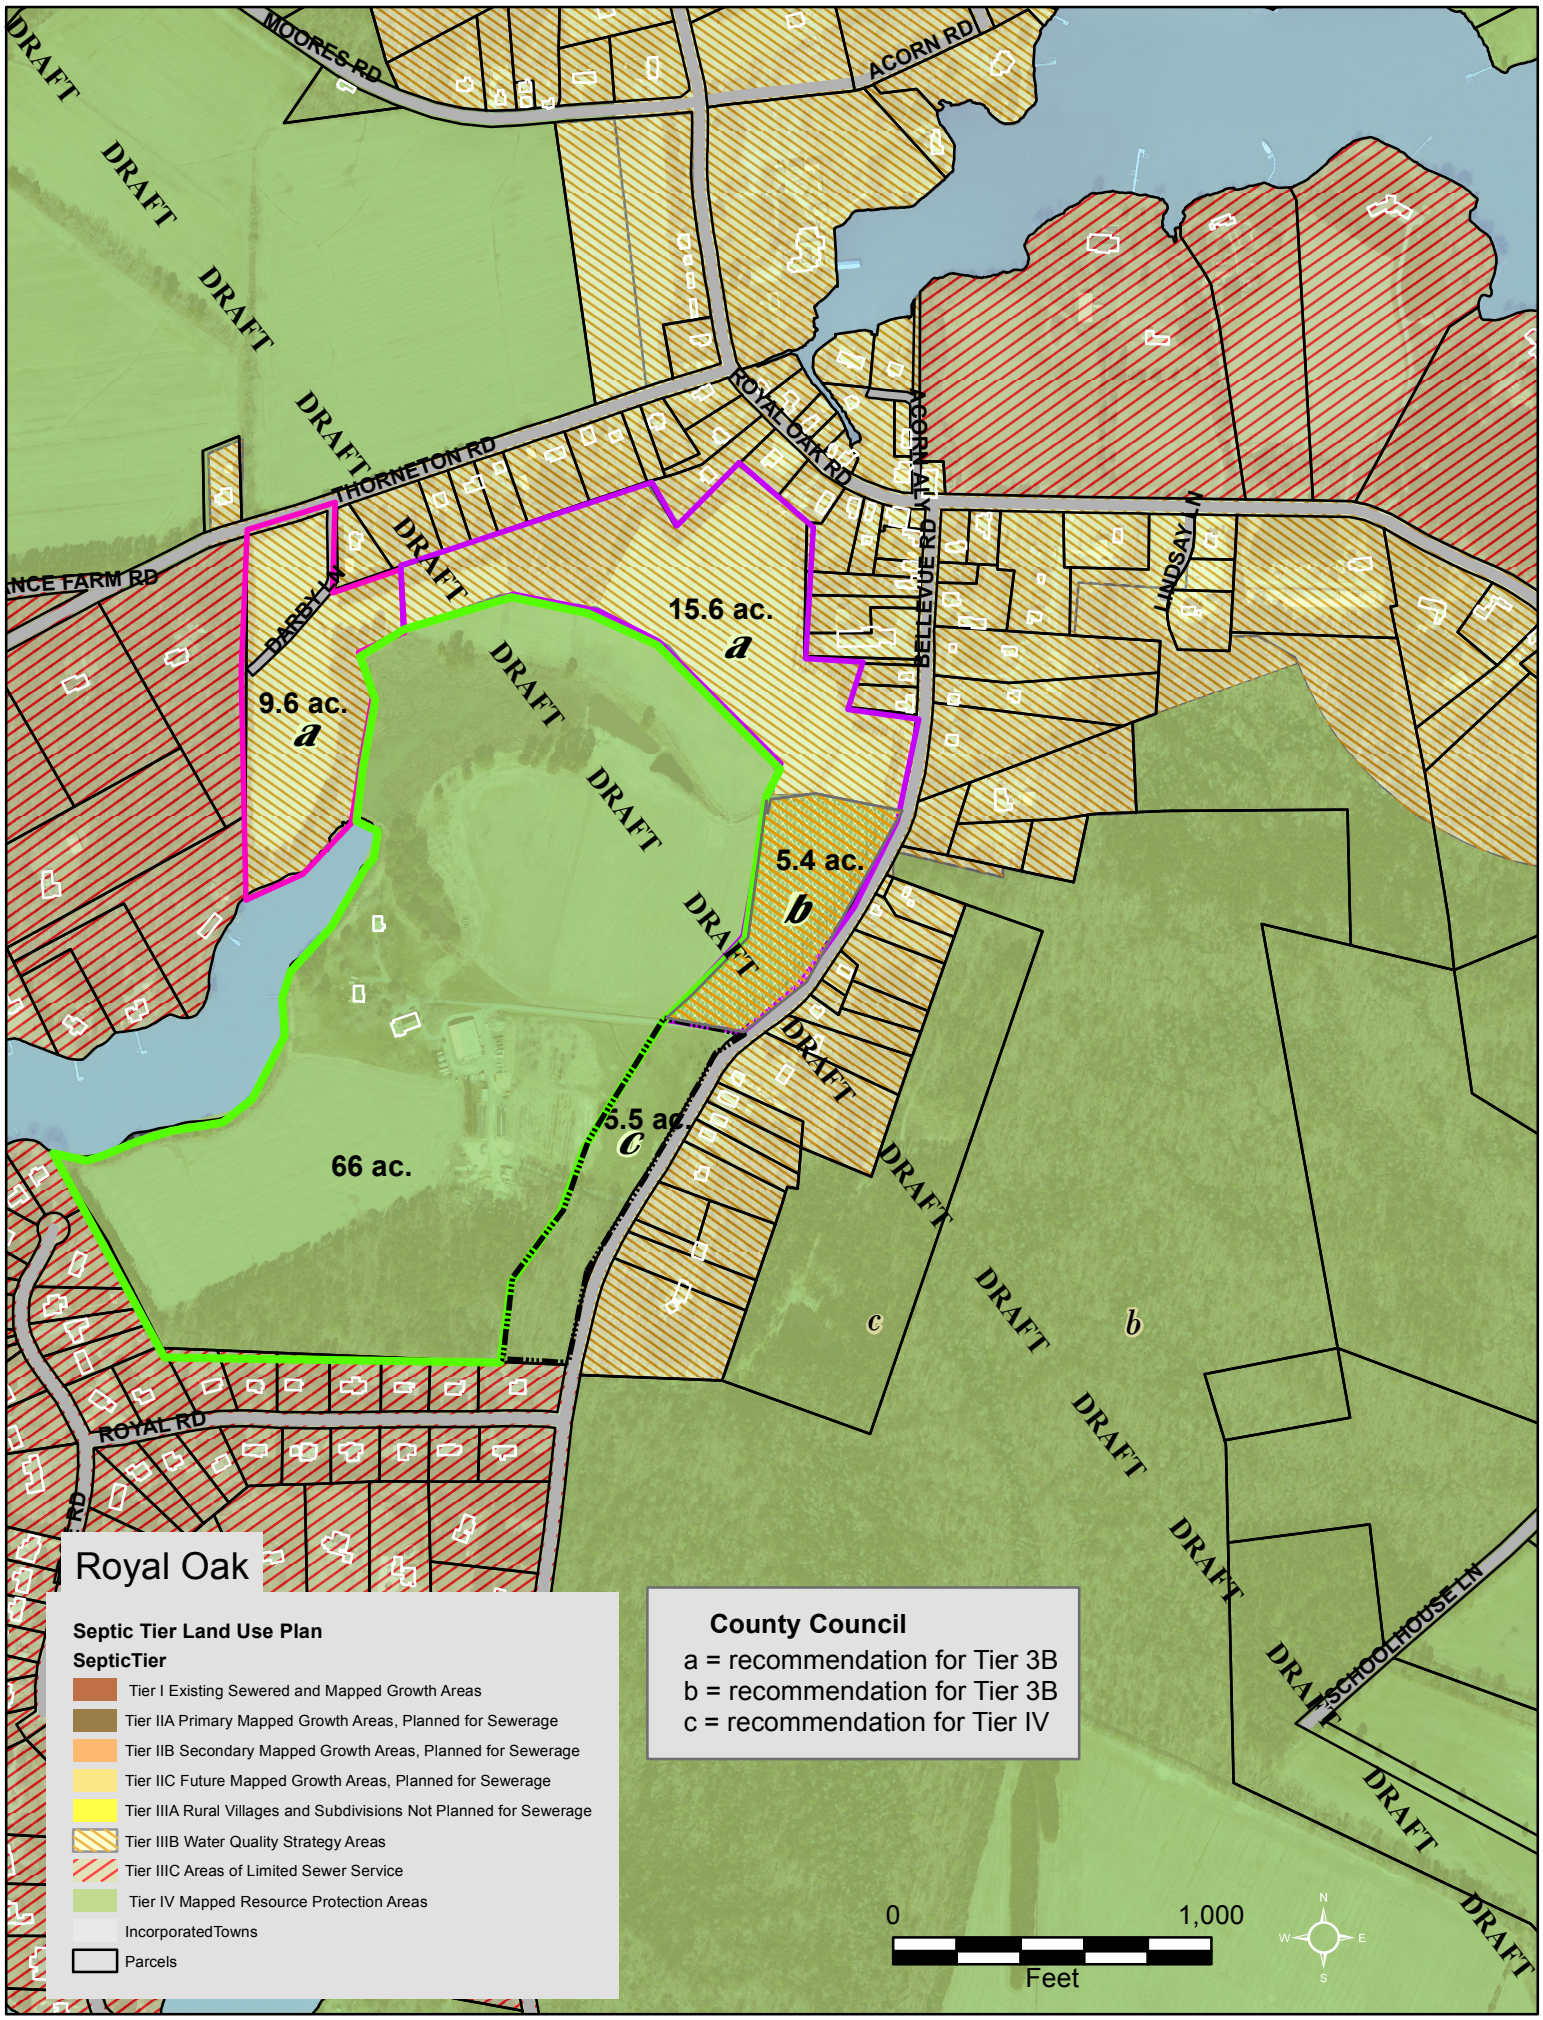
Royal Oak
Septic Tier Land Use Plan
SepticTier
Tier I Existing Sewered and Mapped Growth Areas
Tier IIA Primary Mapped Growth Areas, Planned for Sewerage
Tier IIB Secondary Mapped Growth Areas, Planned for Sewerage
Tier IIC Future Mapped Growth Areas, Planned for Sewerage
Tier IIIA Rural Villages and Subdivisions Not Planned for Sewerage
Tier IIIB Water Quality Strategy Areas
Tier IIIC Areas of Limited Sewer Service
Tier IV Mapped Resource Protection Areas
IncorporatedTowns
Parcels
County Council
a = recommendation for Tier 3B
b = recommendation for Tier 3B
c = recommendation for Tier IV
0
1,000
Feet
N
W
E
S
MOORES RD
ACORN RD
THORNETON RD
ROYAL OAK RD
BELLEVUE RD
LANDSAY LN
DARBY LN
ROYAL RD
SCHOOLHOUSE LN
15.6 ac.
a
9.6 ac.
a
5.4 ac.
b
5.5 ac.
c
66 ac.
c
b
DRAFT